


- NOTES:
- THIS DRAWING WAS COMPILED FROM INFORMATION PROVIDED BY WANZEK, UTILIZING INFORMATION FROM THE FOLLOWING FILE LIST.
 - a. CRM_AvoidanceBuffer_110813.SHX
 - b. USFWS_WetEase_1012.SHX
 - c. Wetlands_Poly_102314.SHX
 - d. Courtenay_TurbineArrayRenumbering_2015_07_15.SHX
 - e. Courtenay ALTA 150120.DWG
 - f. Courtenay_CollectionRecordLines_20161108.SHP
 - g. Courtenay_AdditionalSurveyCorridor_2015_10_07.kmz
 - THE AERIAL WAS OBTAINED BY ULTEIG.
 - g. CourtenayAerial_NDStateplane_HarrNAD83_South_IntlFt.SID

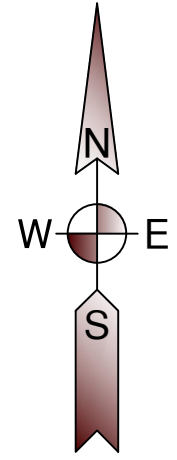

RECORD DRAWING
DRAWINGS ARE BASED UPON
CONSTRUCTION CONTRACTOR REDLINES
WHICH HAVE NOT BEEN FIELD VERIFIED BY
ENGINEER OF RECORD.

LEGEND	
	WIND TURBINE
	FEEDER 1
	FEEDER 2
	FEEDER 3
	FEEDER 4
	FEEDER 5
	FEEDER 6
	FEEDER 7
	FEEDER 8
	FIBER ROUTE
	SURVEYED CORRIDORS
	RIGHT OF WAY
	NON LEASED
	JUNCTION BOX
	CABLE SPLICE
	FIBER SPLICE
	MID SPAN GROUND
	ACCESS ROADS
	BORE LOCATION [RB X-X]

NO	REVISION						NO	REVISION						REFERENCE DRAWINGS		
	DATE	BY	CHK	ENG				DATE	BY	CHK	ENG			DWG NO.	MANUFACTURER	DESCRIPTION
A	01/22/2016	MJ	JH	BG												
0	02/10/2016	AS	JH	BG												
1	12/05/2016	CL	JH	BG												
2		GP	JH	BG												

NORTHERN STATES POWER

COURTENAY WIND - COLLECTION SYSTEM

STUTSMAN COUNTY, NORTH DAKOTA

DWN: MJ	DATE:01/22/2016	CHK:	DATE:
ENG: BG	DATE:01/22/2016	CHK:	DATE:
PM: BD	DATE:01/22/2016	PROJ. NO: 121901101	
APVD:	DATE:	SCALE:NONE	

THIS MAP/DOCUMENT IS A TOOL TO ASSIST EMPLOYEES IN THE PERFORMANCE OF THEIR JOBS. YOUR PERSONAL SAFETY IS PROVIDED FOR BY USING SAFETY PRACTICES, PROCEDURES, AND EQUIPMENT AS DESCRIBED IN THE SAFETY TRAINING PROGRAMS AND MANUALS.

ENERGY SUPPLY
ENGINEERING & CONSTRUCTION

UNIT 0

FEEDER ROUTING DIAGRAM
SECTION 22, T143N, R63W

NH-271536-30	REV 2
--------------	----------